




Guardrail

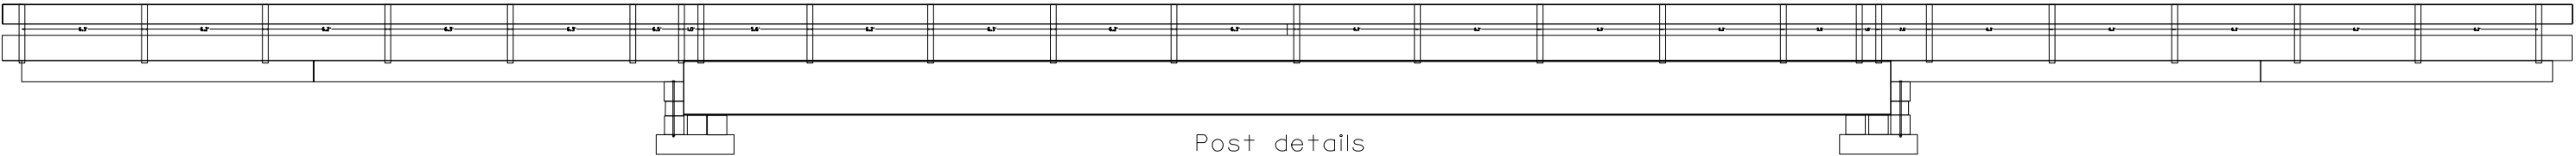


Post details

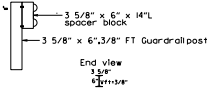

End view of deck

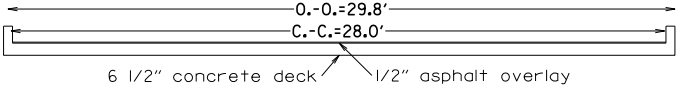

Soundings
Overall length=132.0'

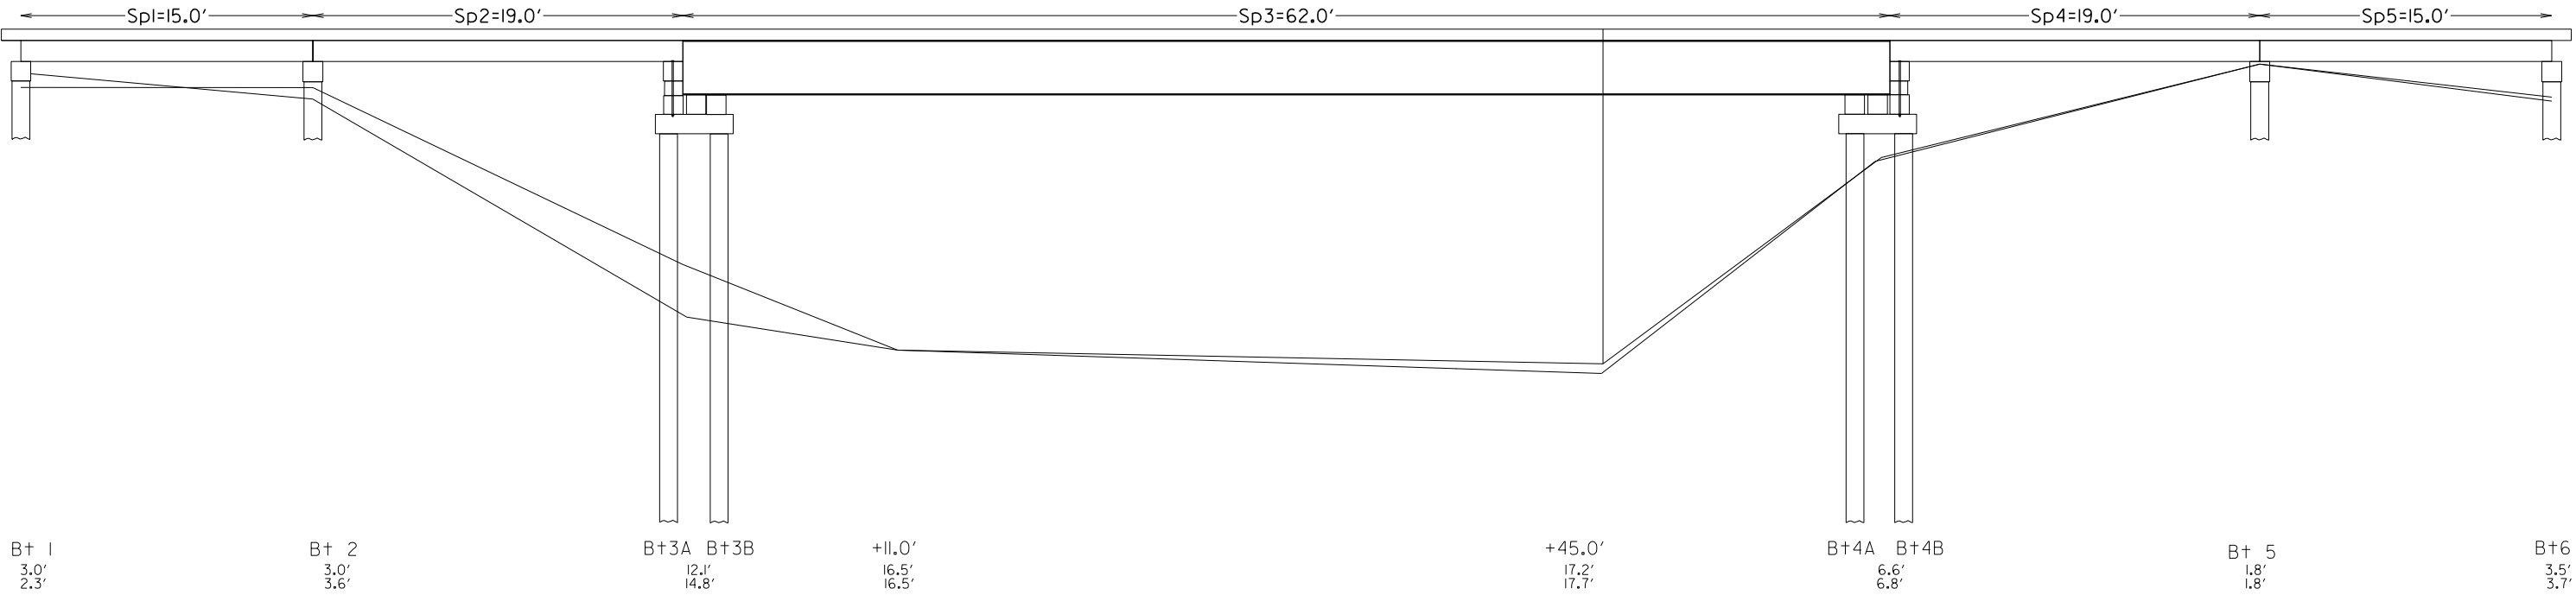

Channel sounded top of deck, left side, upstream.
Green lines & readings: 08-04-2004
Red lines & readings: 07-22-2010