


Channel profiled from top of deck on Lt side (upstream side)

Red lines & readings: 12-06-2010

Blue lines & readings: 9-24-2018

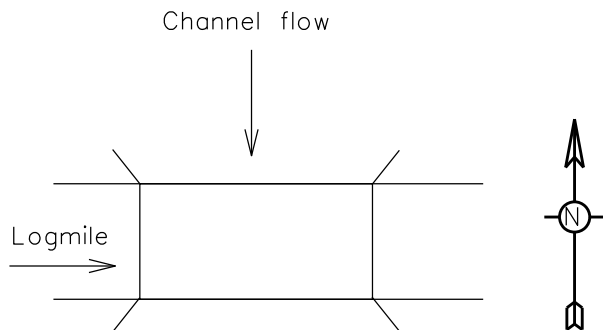

\*Not to Scale

Bridge No. 22046	Dist. 10	Co. Clay
Logmile 8.30	CR39(911=406)	Sect/Zone - I
Date Drawn 9-24-18	Insp. / Assist.	JFA / CWS