


Channel profiled from top of deck on left side (downstream side)

Green line and soundings taken on 5/30/2006

Red line and soundings taken on 5/8/2012

Orange line and soundings taken on 5/19/2020

Pink soundings taken on 5/01/2024

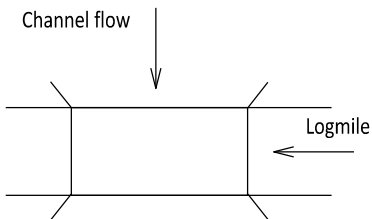

Scale: 1"=8'

Inspection Dir: E to W

Channel Flow: N to S

BRIDGE NO.

22902

Logmile: 3.51

Route: CR 872

Date Drawn: 05/01/24

Insp. / Assist.: BDS / DJW

District: 10


County: Craighead - 16

Sect/Zone: 00/A



ARKANSAS STATE HIGHWAY COMMISSION  
Little Rock, ARK.

Bent 2 Substructure

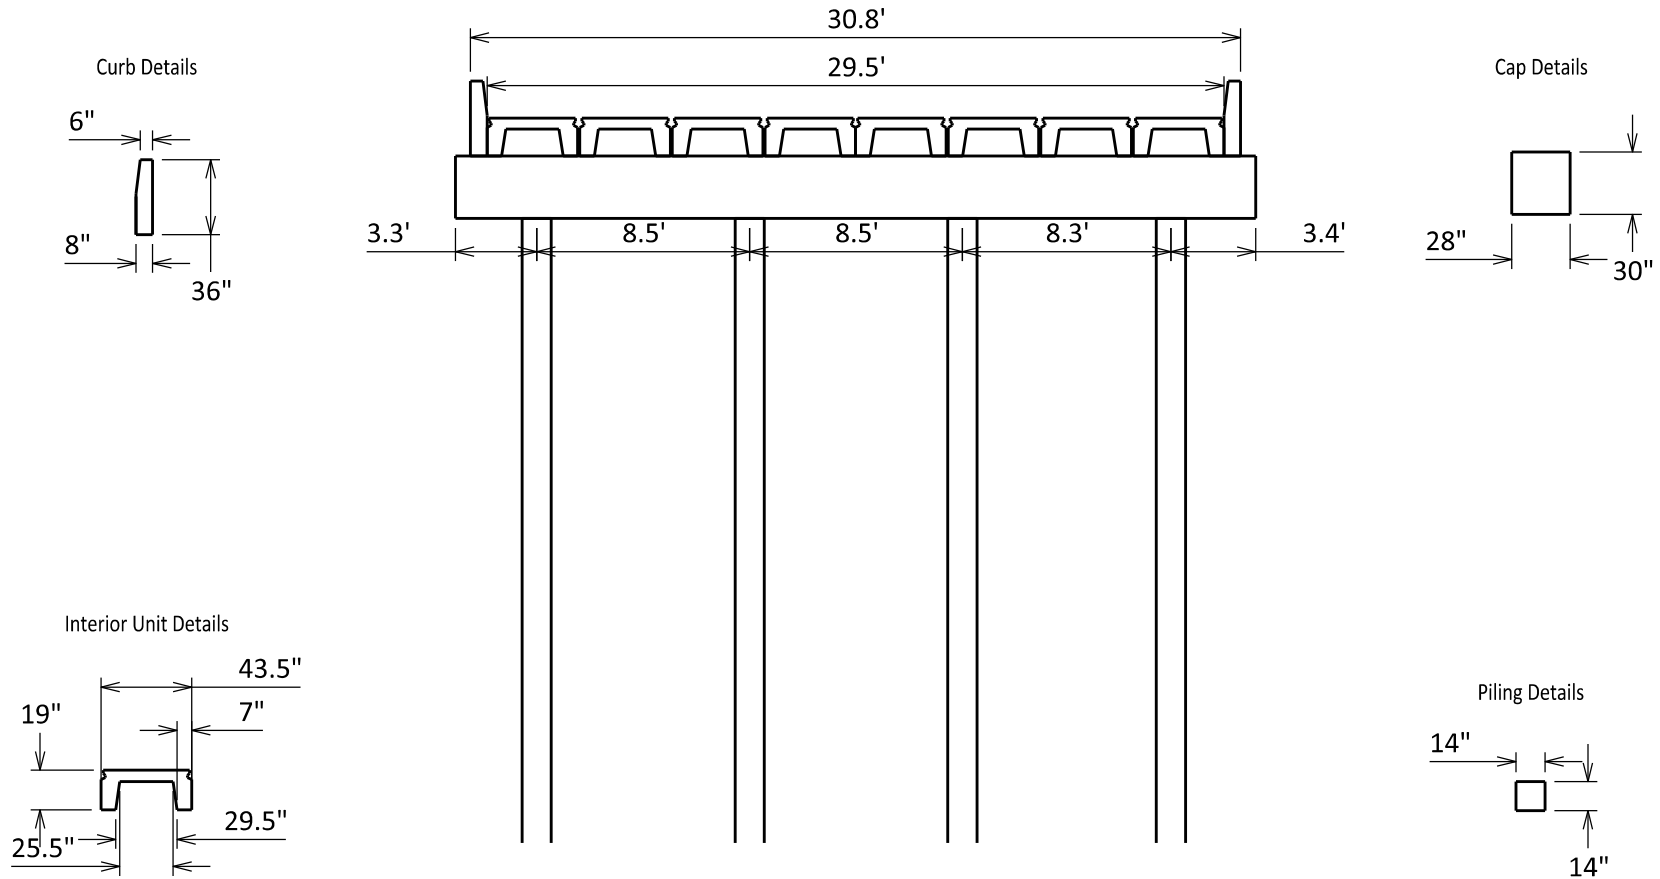

BRIDGE NO.

22902

District: 10

County: Craighead - 16

ARKANSAS STATE HIGHWAY COMMISSION  
Little Rock, ARK.

Scale: 1"=5'

Inspection Dir: E to W

Channel Flow: N to S

Logmile: 3.51

Route: CR 872

Date Drawn: 05/01/24

Sect/Zone: 00/A

Insp. / Assist.: BDS / DJW

